

IN THE UNITED STATES PATENT AND TRADEMARK OFFICE

In re application of: Hovhannes Ghukasyan et al.

Application No.: 09/871,485

Group No.: 2168

Filed: 05/31/2001

Examiner: Hung Q. Pham

For: "DYNAMIC DATABASE MANAGEMENT SYSTEM AND METHOD"

May 17, 2006

Mail Stop Amendment
Commissioner for Patents
P.O. Box 1450
Alexandria, VA 22313-1450

**SUBMISSION OF PROPOSED DRAWING AMENDMENT
FOR APPROVAL BY EXAMINER**

Attached please find a copy of the original Figure 15 with markings, showing the proposed changes to the drawing in this application, for which the approval of the Examiner is requested. A Replacement Sheet is also enclosed for substitution of the originally filed Figure 15.

Date: May 17, 2006



Signature of Practitioner

Reg. No.: 33834
Tel. No.: (408) 451-5902
Customer No.: 35273

Patrick T. Bever
Bever, Hoffman & Harms, LLP

RED-LINED MARKED-UP VERSION

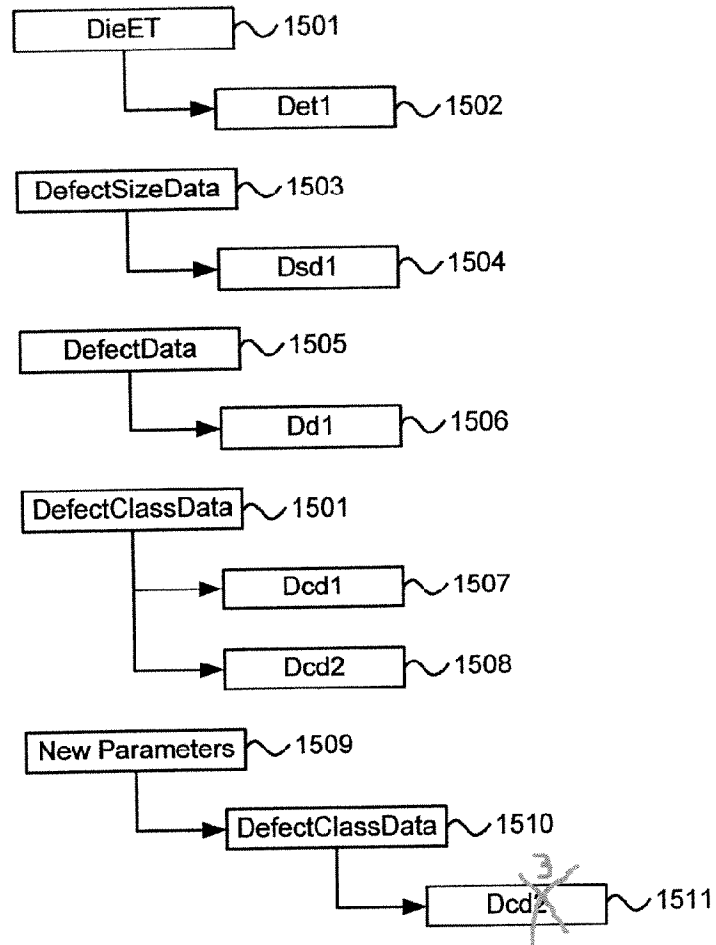


FIG.15

REPLACEMENT SHEET

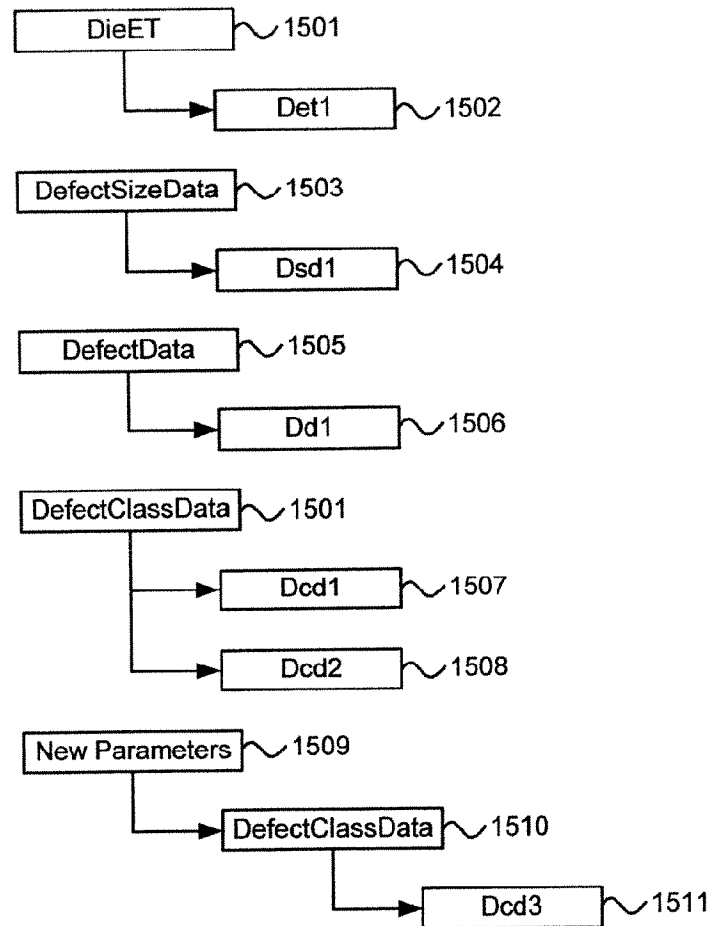


FIG.15